THIS DOCUMENT CONTAINS PROPRIETARY INFORMATION WITH ALL RIGHTS AND TITLES RESERVED AND MAY NOT BE REPRODUCED IN WHOLE OR PART WITHOUT WRITTEN CONSENT OF IMI CCI.

SOLIDWORKS Generated Dwg.

ITEM NO.	DESCRIPTION	MATERIAL	QTY.	REMARKS
1	BODY	ASTM-A182-F91	1	
2	SEAT RING	2.25 Cr - 1Mo	1	STELLITE
3	GASKET FLEXITALLIC	347/CARB	3	
4	DISK STACK	INCONEL 718	1	
5	GUIDE BUSHING	2.25 Cr - 1Mo	1	
6	SEAL, BALANCE	GARLOCK	1	
7	BONNET SPACER	2.25 Cr - 1Mo	1	
8	PLUG	2.25 Cr - 1Mo	1	STELLITE
9	STEM	INCONEL 718	1	
10	GASKET, FLEXITALLIC	347/CARB	1	
11	BONNET	ASTM-A182-F91	1	
12	STUD	ASTM-B637N07718	10	
13	NUT	ASTM-A194 GR3	10	
14	PACKING SPACER	CARBON	1	
15	PACKING SET	GRAPHITE	1	GARLOCK
16	YOKE	CARBON STEEL	1	
17	ACTUATOR	IMI STI	1	SC/V 400
18	DESUPERHEATER	ASTM-A335-P22	1	
19	SPRAY WATER INLET	ASTM-A182-F22	1	
20	NOZZLE HOUSING	ASTM-A182-F22	3	
21	NOZZLE END PLATE	ASTM-A182-F22	3	
22	STUD, NOZZLE	ASTM-A193-B16	8	PER NOZZLE
23	NUT, NOZZLE	ASTM-A194 GR3	8	PER NOZZLE
24	WSHR, NOZZLE	300 SERIES	8	PER NOZZLE
25	SPACER, NOZZLE	2.25 Cr - 1Mo	1	PER NOZZLE
26	STEM PACKING	GRAPHITE	2	PER NOZZLE
27	NOZZLE RETAINER	2.25 Cr - 1Mo	1	PER NOZZLE
28	GASKET	GRAPHITE	1	PER NOZZLE
29	DESUPERHEATER NOZZLE	IMI CCI	3	OP-4010
30	TAB WASHER	300 SERIES SS	1	PER NOZZLE
31	PIPE EXTENSION	ASTM-A335-P91	1	
32	WARMING CONNECTION	ASTM-A182-F91	1	

ENGINEERING DATA


CERTIFICATION	
PRESSURE CLASS	ASME 2500 (9)
DESIGN PRESSURE	2040 psi G
DESIGN TEMPERATURE	1065 °F
MAX. PRESS. @ 100°F (38°C)	6250 psi G
NUCLEAR CLASS	---
HYDROTEST PRESSURE	9375 psi G (8) / 750 psi G (11) / 1680 psi G (12)
MAX. Cv @ 100% STROKE	430
MAX. SEAT LEAKAGE	6.1 cc/min @ 2040 psi G (6)
BONNET FLANGE NUT TORQUE	1777-1964 ft-lbf


OPERATOR	
TYPE	PNEUMATIC PISTON, DOUBLE ACTING
SUPPLY	60-125 psi G
SIGNAL	IN 4-20 mA OUT 4-20 mA (10)
INCREASING SIGNAL	TO OPEN THE VALVE
SHAFT	EXTENDS TO CLOSE ELEMENT
FAILURE POSITION / MECHANISM	CLOSE / VOLUME TANK
NOMINAL STROKE	8 in.
STROKE TIME	<4 s OPEN <4 s CLOSE
VALVE AND OPERATOR WEIGHT (APPROX.)	4237 lbs


DESUPERHEATER	
MODEL	DAM-D
DESIGN PRESS / DESIGN TEMP (STEAM)	485 psi G / 1065°F
DESIGN PRESS / DESIGN TEMP (WATER)	1120 psi G / 560°F
NOZZLE END PLATE NUT TORQUE	75 FT-LBS

NOTES:


1. VALVE ORIENTATION TO BE STEM VERTICAL WITH ACTUATOR UP
2. MODEL NO.: 100DHP W/DAM-D DESUPERHEATER
3. IDENTIFICATION CODE: DRAG-SGA2-X6-12BW-12BW-GDEG26-TB
4. ALL DIMENSIONS WITHOUT STATED TOLERANCES ARE FOR REFERENCE ONLY
5. BECHTEL TAGGING TO BE FOLLOWED
6. SEAT LEAKAGE PER ANSI/FCI 70.2, CLASS V
7. ALL DIMENSIONS ARE IN INCHES
8. HYDROTEST OF VALVE BODY AND PIPE EXTENSION ONLY
9. ASME PRESSURE CLASS RATED FOR VALVE BODY, DESUPERHEATER & PIPE EXTENTION SECTION RATED TO ASME B31.1
10. VALVE PROVIDED WITH TWO POSITION TRANSMITTERS.
11. HYDROTEST OF VALVE BODY, PIPE EXTENSION AND DESUPERHEATER.
12. HYDRO TEST OF WATER CONNECTION & MANIFOLD.

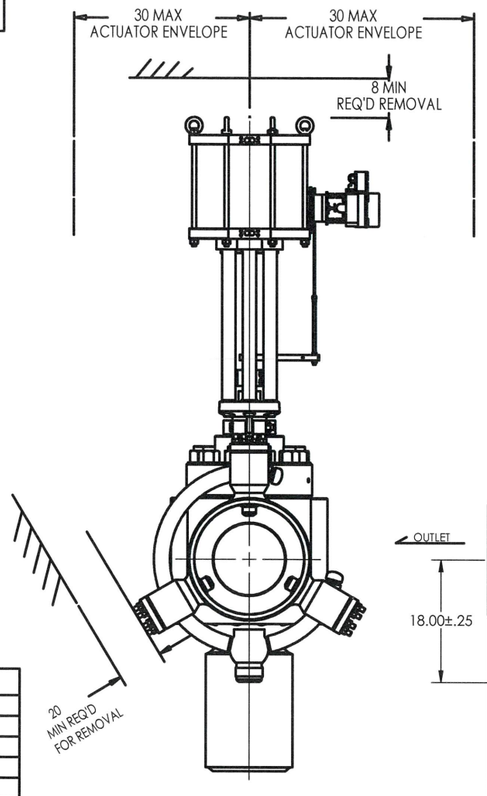

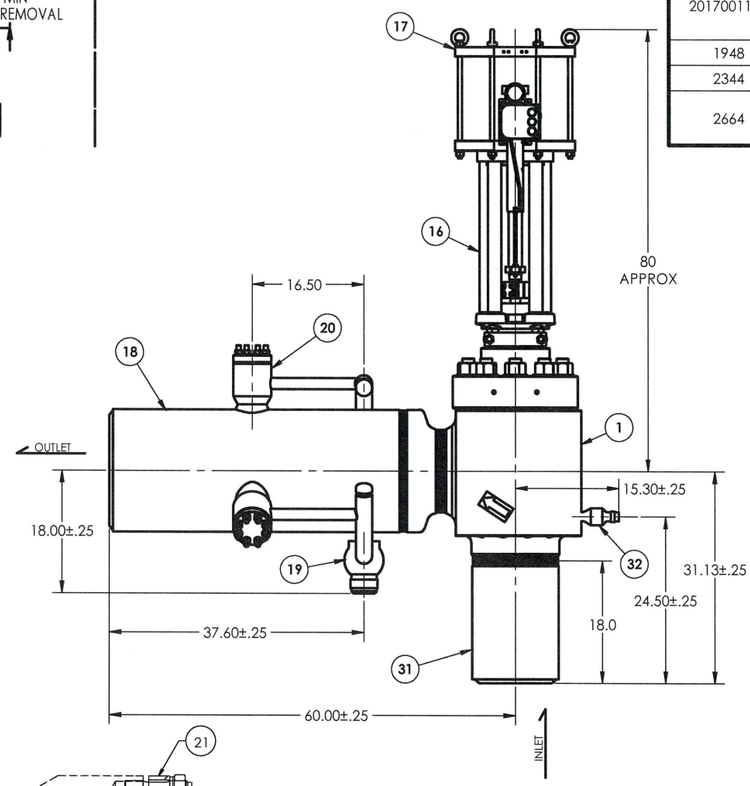

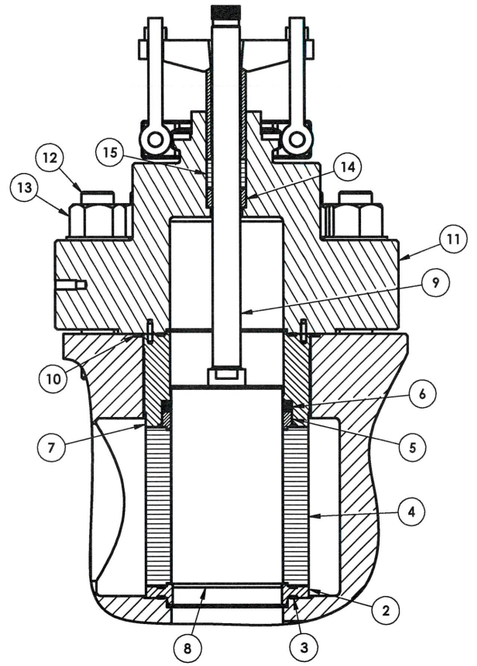

SECTIONAL VIEW

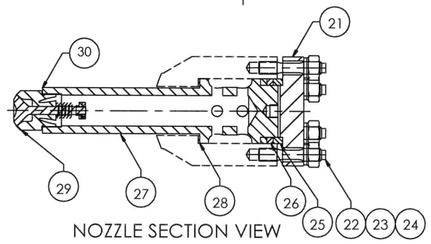

NOZZLE SECTION VIEW


CRICKET VALLEY ENERGY CENTER

BECHTEL INFRASTRUCTURE AND POWER CORPORATION


PURCHASE ORDER 26068-230POA-MS00-00001

EQUIPMENT SCOPE: BOP

WARMING LINE CONN: 1" SCH XXS

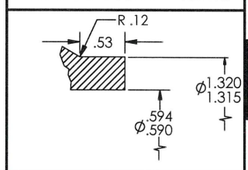


INLET CONNECTION: 12" SCH 140

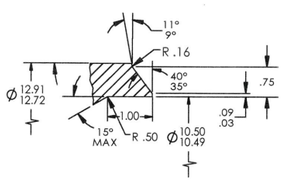


B16.25 FIG 3A

OUTLET CONNECTION: 18" SCH 80

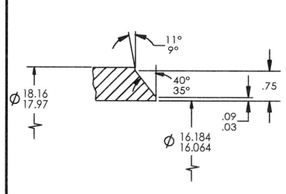


B16.25 FIG 3A

WATER INLET CONN: 3" SCH XS

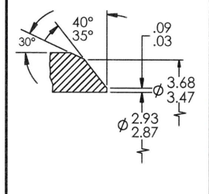

B16.25 FIG 2A

108384-010-03	03-AB-PV-100
108384-010-02	02-AB-PV-100
108384-010-01	01-AB-PV-100
SERIAL NO.	**TAG NO.**

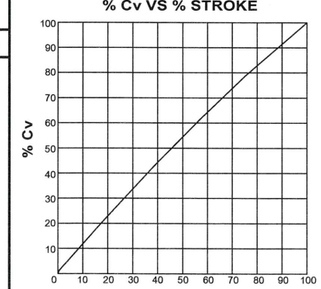

REVISIONS

E.O. NO	REV. LTR.	DESCRIPTION	DATE	APPROVED
2017000883	NC	NEW RELEASE	11-AUG-17	F. AHMED
2017001109	A	ADDED ITEM 32, ADD VALVE/TANK TAG NO, REV CONTROL SCH, ADD WIRING DIAGRAM, REV INLET, OUTLET, WATER INLET ID DIM, ADD WARM CONN, REV NOTE5 & 8, ADD NOTE 10 & 11	20-NOV-17	J. H.
1948	B	REV SW 1" SCH XXS WARMING CONN	21-DEC-17	J. H.
2344	C	ITEM 29 REMARKS WAS OP-4030	26-MAR-18	J. H.
2664	D	ADD NOTE 12; REV CONTROL SCHM SHT 2; WIRING DIAGRAM SHT 3; WATER DESIGN CONDITIONS CHANGED; REVISED AS BUILT	29Jun18	JH

GE ENERGY

GENERAL ELECTRIC COMPANY
GENERAL ELECTRIC INTERNATIONAL. INC.
POWER GENERATION-PROJECT ENGINEERING

GENERAL ASSEMBLY DRAWING

PROJECT NO: 1032773

FIRST MADE FOR CRICKET VALLEY ENERGY CENTER

SIZE	CAGE CODE	DWG NO MDL NO
SCALE	EQUIP NO.	SHEET OF

CERTIFICATION

CUSTOMER	GE POWER
P.O.	4101407006
PROJECT	CRICKET VALLY TBS
STATION	CRICKET VALLEY ENERGY CENTER **UNIT**
CONTRACT NO. :	

IMI CCI 22591 Avenida Empresa Rancho Santa Margarita California, 92688 U.S.A. IMI Critical Engineering

DRAG® VALVE

12" X 12" ASME 2500 ANGLE VALVE
WITH 12" X 12" INLET EXTENSION AND
12" X 18" DAM-D DESUPERHEATER

PREP:	J. CAGLE	08-AUG-17
CHK:	J. HEIDENREICH	08-AUG-17
DSGN:	J. CAGLE	08-AUG-17
PROJ:	J. HEIDENREICH	08-AUG-17
APVD:	R. GRABLE	08-AUG-17

SIZE D

DRAWING NUMBER 800289-1

SCALE: NONE SHEET 1 OF 3


Document Status: RELEASED
IMI CCI Digital Product System

IMI CCI – Digital Paper System


THIS DOCUMENT CONTAINS PROPRIETARY INFORMATION WITH ALL RIGHTS AND TITLES RESERVED AND MAY NOT BE REPRODUCED IN WHOLE OR PART WITHOUT WRITTEN CONSENT OF IMI CCI.


PARTS LIST


ITEM	DESCRIPTION	MATERIAL	QTY	REMARKS
A	ACTUATOR	STI	1	SC/V 400
P	POSITIONER	FISHER	1	DVC6200 HW2
TP	PRESSOSTATIC HEAD	STI	1	TP
AFR	AIR FILTER REGULATOR	NORGEN	1	B74 3/4" ALU
BD	DERVATVE	STI	2	BD 1"
ZT1	POSITION TRANSMITTER	FISHER	1	INTO POSITIONER
ZT2	POSITION TRANSMITTER	SOLARTRON	1	LVDT
B	CHECK VALVE	NORGEN	1	1/2" ALU
D1-2	3 WAY VALVE	STI	2	CO 1/2"
AB	AIR TANK	MANCHESTER	1	113L
F	AIR FILTER	NORGEN	1	F68 1"
SV	SAFETY VALVE	N.G.I.	1	C10 BRASS
DV	DRAIN VALVE	M.B.VALVE	1	IVR 660
G	GAUGE	STI	1	STI
EV	SOLENOID VALVE	MAXSEAL	1	IC03S
LS	LIMIT SWITCHES	HONEYWELL	2	GLA SERIES
PS	PRESSURE SWITCH	TELEMELANIQUE	1	XMLA010A2S11

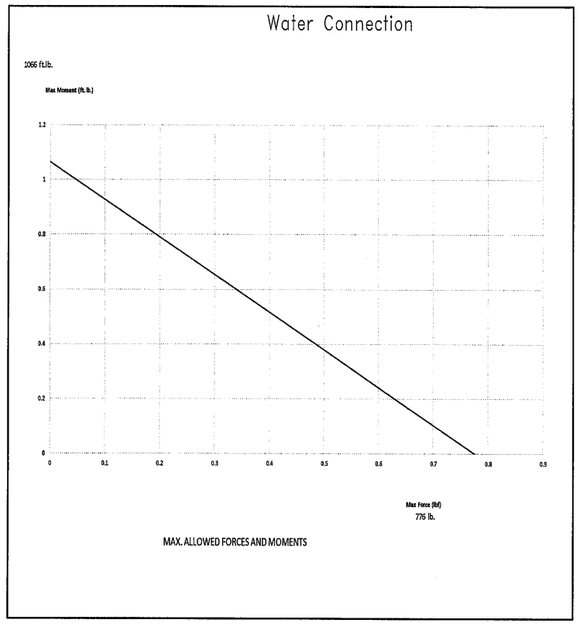

MAX. ALLOWED FORCES AND MOMENTS

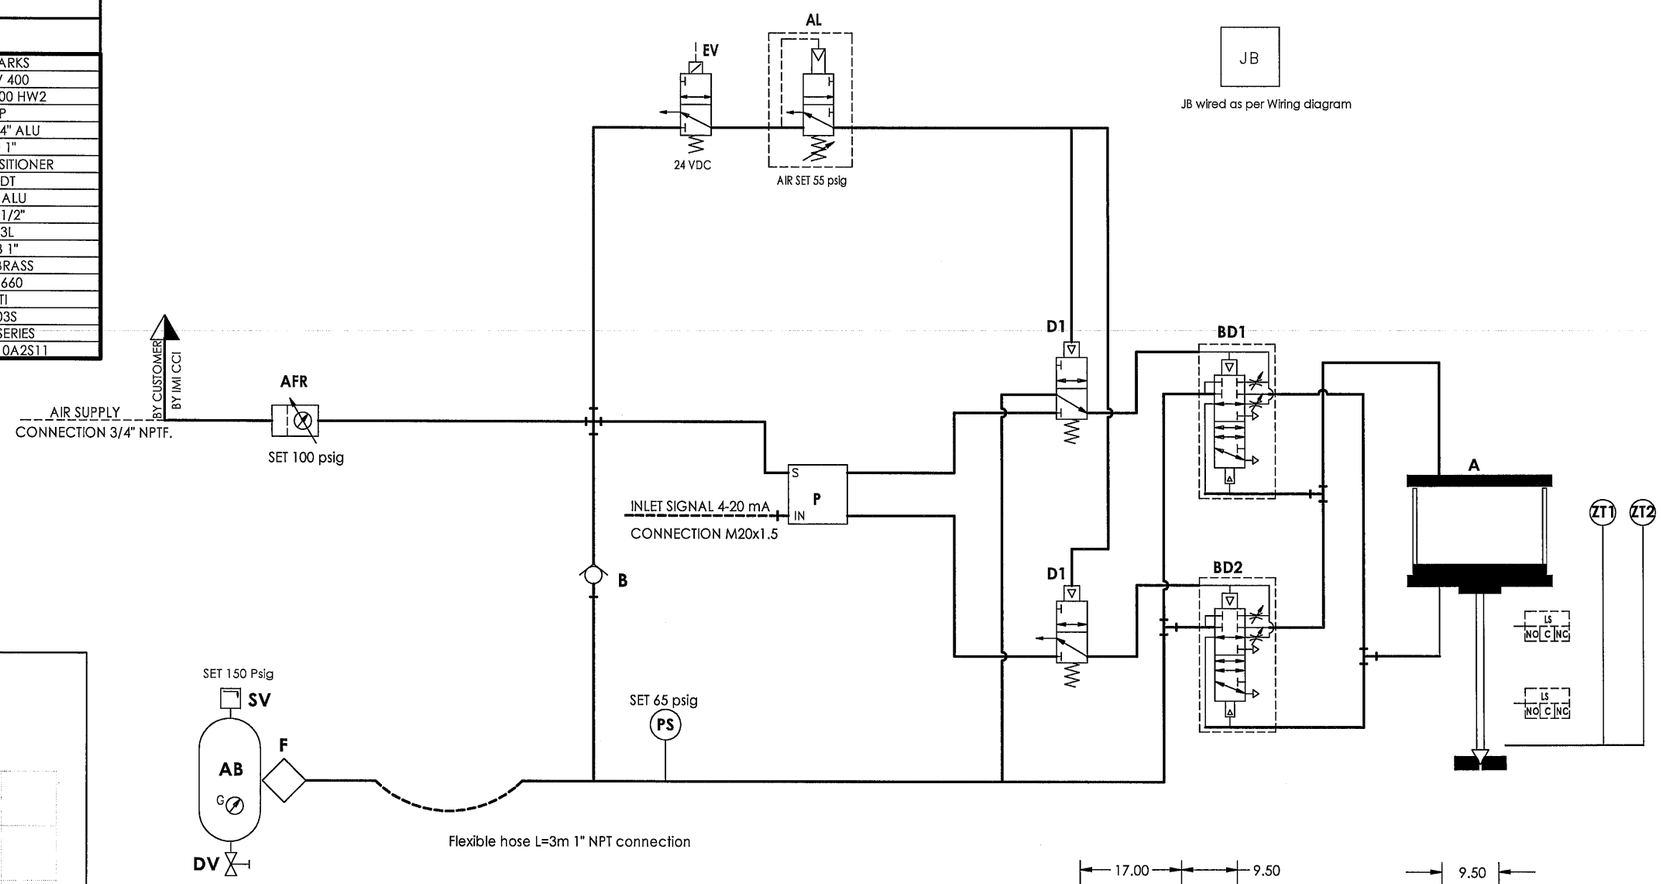

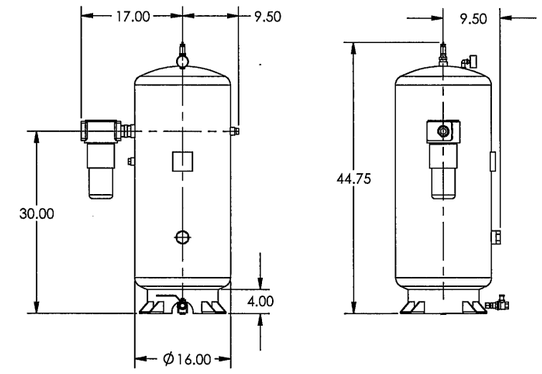

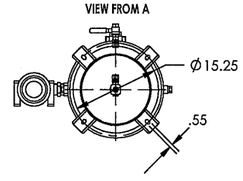


VALVE TAG NO.	TANK TAG NO.
01-AB-PV-100	01-AB-MT-100
02-AB-PV-100	02-AB-MT-100
03-AB-PV-100	03-AB-MT-100

CONTROL LOGIC				
SIGNAL	OK	ANY	FAIL	ANY
SOLENOID	ENERGIZED	ENERGIZED	ENERGIZED	DE-ENERGIZED
AIR SUPPLY	OK	FAIL	OK	OK
VALVE POSITION	MODULATING	CLOSED	CLOSED	CLOSED


Document Status: RELEASED

SIZE	DRAWING NUMBER
D	800289-1
REVISION D	SHEET 2 OF 3

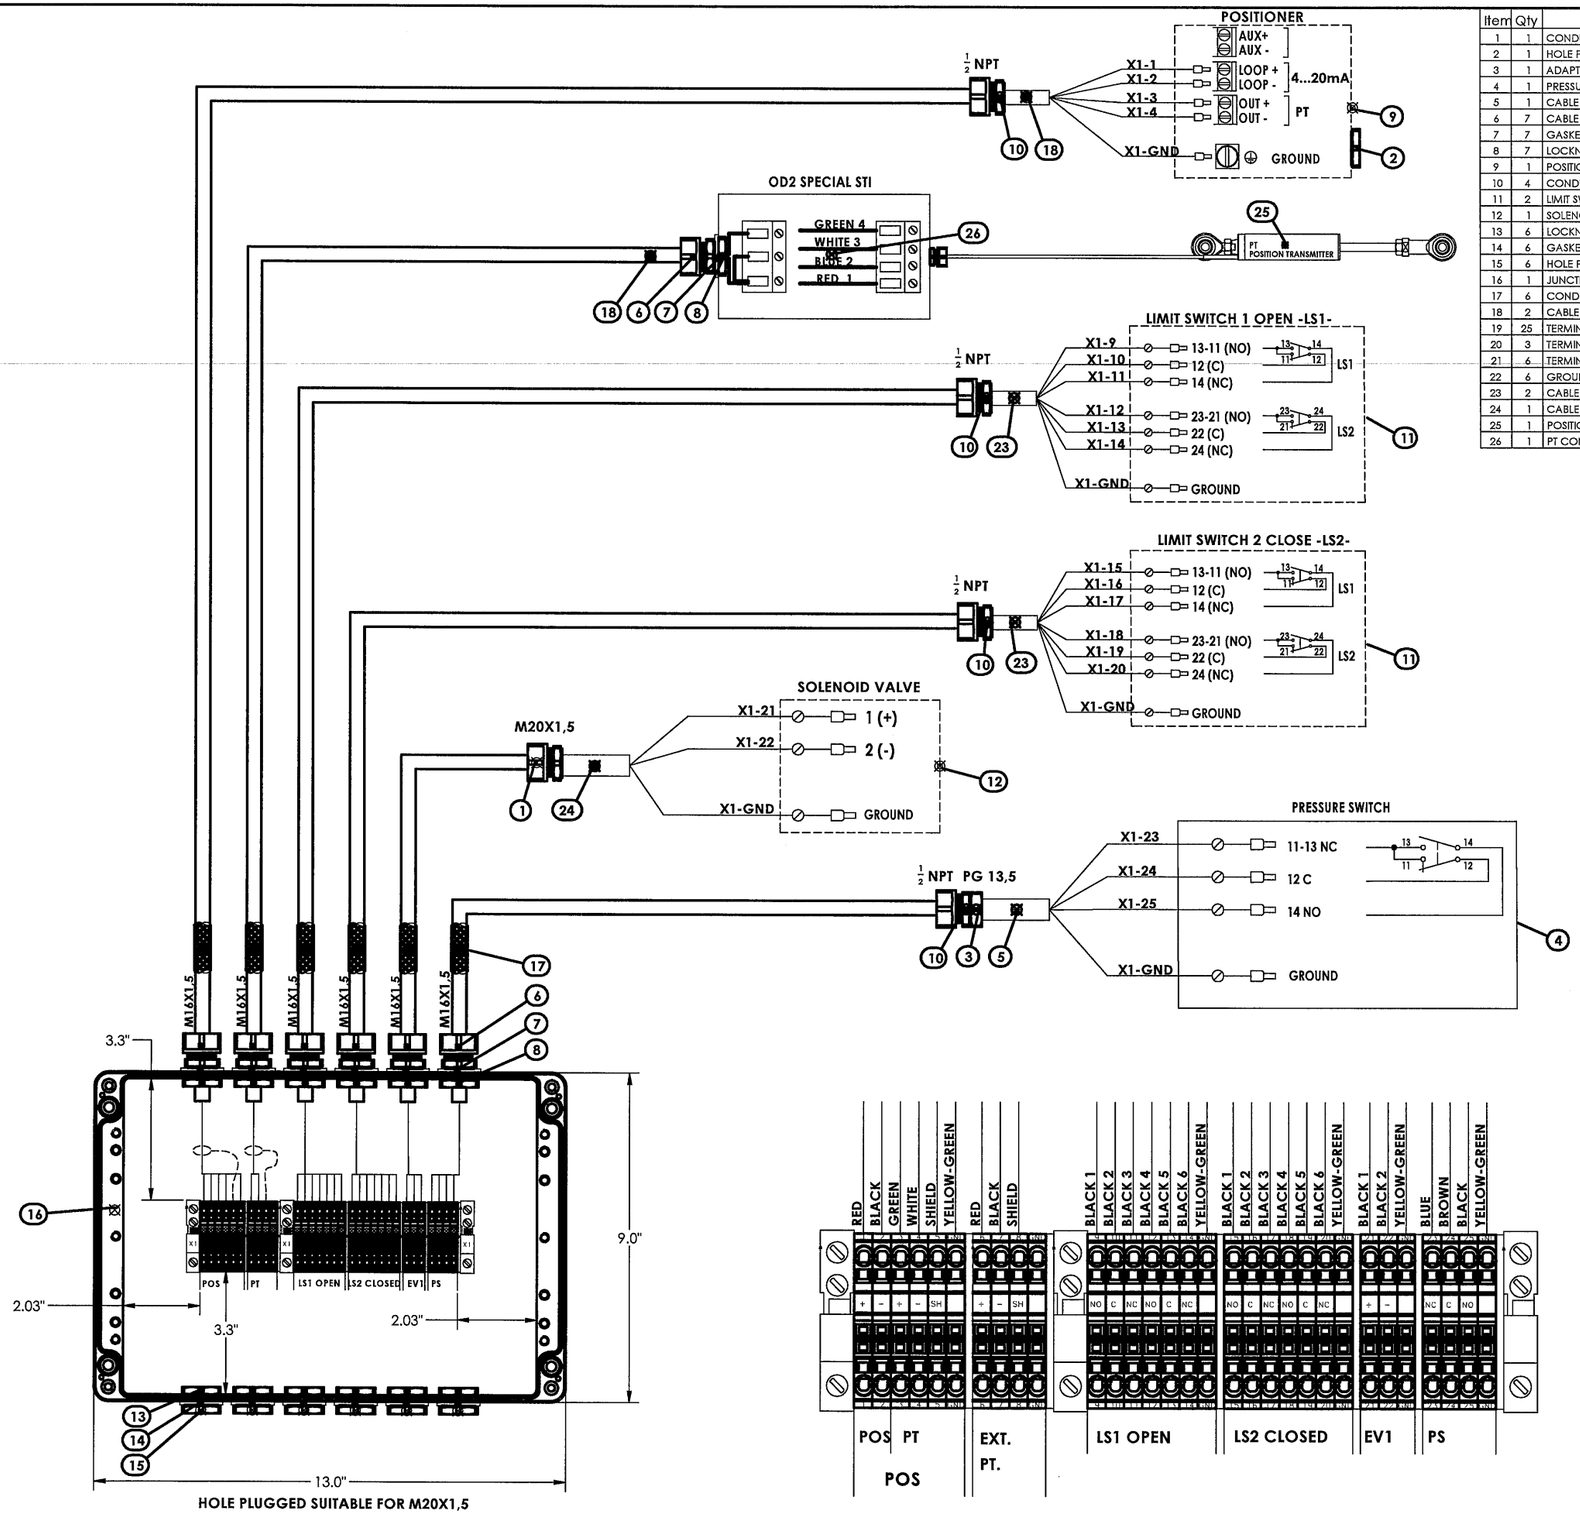

Item	Qty	Description	Vendor	Part number
1	1	CONDUIT FITTING	ANAMET 712.117.9	147025
2	1	HOLE PLUG	PEPPERS SPMH1SF/050NPT 1/2NPT	109236
3	1	ADAPTER	PEPPERS AR0SF/PG13/050NPT	149509
4	1	PRESSURE SWITCH	TELEMECANIQUE XMLA010A2S11	
5	1	CABLE	ELETTROTEKKABEL FROR 4G1 CC500	109333
6	7	CABLE CONDUIT	ANACONDA M16X1.5 712.116.9	109197
7	7	GASKET	PEPPERS ACNSW/M16	109206
8	7	LOCKNUT	PEPPERS ACSLN/M16	109204
9	1	POSITIONER	FISHER 6200 HC HW2	
10	4	CONDUIT GLAND	ANACONDA STEALTITE 1/2"NPT 714.112.9 AISI 316	109193
11	2	LIMIT SWITCH	HONEYWELL GLAA DPDT	
12	1	SOLENOID VALVE	MAXSEAL ICO3S	
13	6	LOCKNUT	PEPPERS ACSLN/M20 M20X1.5	109202
14	6	GASKET	PEPPERS ACNSW/M20 M20X1.5	109205
15	6	HOLE PLUG	PEPPERS SPMH1SF/M20	109234
16	1	JUNCTION BOX	ROSE 25.23.33.11	122074
17	6	CONDUIT	ANACONDA STEALTITE H.T.D.L. 3/8" 330.012.2	109213
18	2	CABLE	ELETTROTEKKABEL SRY D321C 4X22 03210422	109216
19	25	TERMINAL	PHOENIX CONTACT ST 2,5	111755
20	3	TERMINAL STOP	PHOENIX CONTACT E/UK	109221
21	6	TERMINAL SEPARATOR	PHOENIX CONTACT TYPE D-ST 2.5	111754
22	6	GROUND TERMINAL	PHOENIX CONTACT ST 2.5-PE	111756
23	2	CABLE	ELETTROTEKKABEL FROR 7G1 CC500	109291
24	1	CABLE	ELETTROTEKKABEL FROR 3G1 CC500	109289
25	1	POSITION TRANSMITTER	SOLARTRON LVDT S-SERIES	
26	1	PT CONVERTER	SOLARTRON OD2 SPECIAL STI	

HOLES ORIENTATION

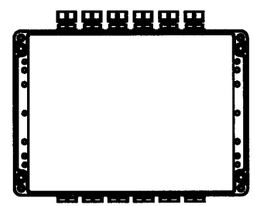

HOLE PLUGGED SUITABLE M20X1,5
CUSTOMER SIDE

HOLES ORIENTATION AND POSITION ARE INDICATIVE. THEY COULD BE CHANGED DURING THE MOUNTING.

SIZE	DRAWING NUMBER
D	800289-1
REVISION D	SHEET 3 OF 3