IMI CCI – Digital Paper System

THIS DOCUMENT CONTAINS PROPRIETARY INFORMATION WITH ALL RIGHTS AND TITLES RESERVED AND MAY NOT BE REPRODUCED IN WHOLE OR PART WITHOUT WRITTEN CONSENT OF IMI CCI.


SOLIDWORKS Generated Dwg.

PART LIST


ITEM NO	DESCRIPTION	MATERIAL	QTY	REMARKS
1	BODY	ASTM-A182-F91	1	
2	SEAT RING	9Cr-1Mo-V	1	STELLITE
3	GASKET	GRAPHITE	1	
4	CAGE	9Cr-1Mo-V	1	
5	GUIDE BUSHING	9Cr-1Mo-V	1	
6	BALANCE SEAL	GRAPHLOCK	1	
7	HEX HD CAP SCREW	ASTM-B446	14	
8	WASHER TAB	300 SERIES	14	
9	SPACER BONNET	9Cr-1Mo-V	1	
10	PLUG	9Cr-1Mo-V	1	
11	STEM	INCONEL 718	1	
12	GASKET	GRAPHITE	1	
13	BONNET	ASTM-A182-F91	1	
14	STUD	ASTM-B637-N07718	16	
15	NUT	ASTM-A194 GR3	16	
16	PACKING SPACER	CARBON	1	
17	PACKING SET	GRAPHITE	1	GARLOCK 9000EVSP
18	YOKE	CARBON STEEL	1	
19	ACTUATOR	IMI-STI	1	SC/V 500
20	DESUPERHEATER	ASTM-A335-P22	1	
21	SPRAY WATER INLET	ASTM-A182-F22	1	
22	NOZZLE HOUSING	ASTM-A182-F22	6	
23	NOZZLE END PLATE	ASTM-A182-F22	6	
24	STUD NOZZLE	ASTM-A193-B16	8	PER NOZZLE
25	NUT, NOZZLE	ASTM-194 GR3	8	PER NOZZLE
26	WASHER, NOZZLE	300 SERIES	8	PER NOZZLE
27	SPACER, NOZZLE	2.25Cr - 1Mo	1	PER NOZZLE
28	STEM PACKING	GRAPHITE	2	PER NOZZLE
29	NOZZLE RETAINER	2.25 Cr - 1Mo	1	PER NOZZLE
30	GASKET	GRAPHITE	1	PER NOZZLE
31	DESUPERHEATER NOZZLE	IMI-CCI	6	OP-4030
32	TAB WASHER	300 SERIES	1	PER NOZZLE
33	WARMING CONNECTION	ASTM-A182-F91	1	

REVISIONS

E.O. NO	REV. LTR.	DESCRIPTION	DATE	APPROVED
2017000883	NC	NEW RELEASE	11-AUG-17	F. AHMED
2017001109	A	ADD ITEM 33,ADD VALVE/TANK TAG NO, REV CONROL SCH, ADD WARING DIAGRM, REV INLET CONN, ADD WARM CONN, REV NOTE 5 & 8, ADD NOTE 10 & 11	20-NOV-17	J. H.
1948	B	REV SW 1" SCH XXS WARMING CONN	21-DEC-17	J. H.
2664	C	ADD NOTE 12; REV CONTROL SCHM SHT 2; REV WIRING DIGRAM SHT 3; WATER DESIGN CONDITIONS CHANGED; REVISED AS BUILT	2JUL18	RJG

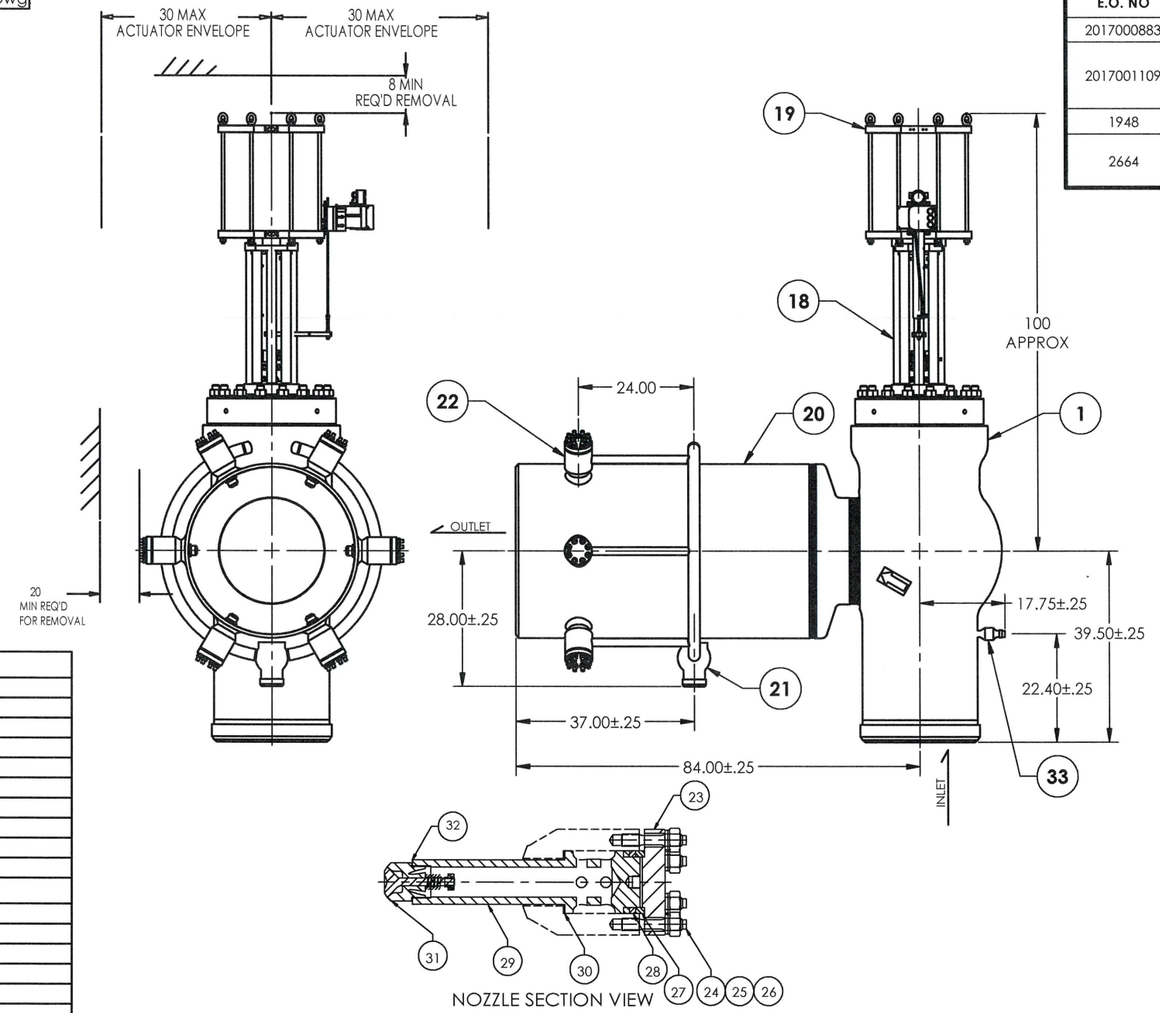

NOZZLE SECTION VIEW

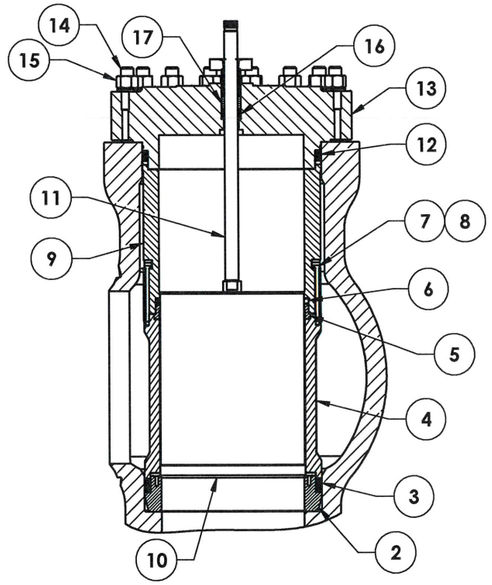

SECTIONAL VIEW

ENGINEERING DATA

CERTIFICATION

PRESSURE CLASS	ASME 600 9
DESIGN PRESSURE	450 psi G
DESIGN TEMPERATURE	1065 °F
MAX. PRESS. @ 100°F (38°C)	1500 psi G
NUCLEAR CLASS	
HYDROTEST PRESSURE	2250 psi G 8 / 150 psi G 11 / 1014 psi G 12
MAX. Cv @ 100% STROKE	3135
MAX. SEAT LEAKAGE	3.5 cc/min @ 450 psi G 6
BONNET FLANGE NUT TORQUE	824-911 ft-lbf

OPERATOR

TYPE	PNEUMATIC PISTON, DOUBLE ACTING
SUPPLY	60-125 psi G
SIGNAL	IN 4-20 mA OUT 4-20 mA 10
INCREASING SIGNAL	TO OPEN THE VALVE
SHAFT	EXTENDS TO CLOSE ELEMENT
FAILURE POSITION / MECHANISM	CLOSE / VOLUME TANK
NOMINAL STROKE NOTES:	16.7 in.
STROKE TIME	<4 s OPEN <4 s CLOSE
VALVE AND OPERATOR WEIGHT (APPROX.)	9453 lbs

DESUPERHEATER

MODEL	DAM-D
DESIGN PRESS / DESIGN TEMP (STEAM)	100 psi G / 1065°F
DESIGN PRESS / DESIGN TEMP (WATER)	676 psi G / 502°F
NOZZLE END PLATE NUT TORQUE	75 FT-LBS

NOTES:

1. VALVE ORIENTATION TO BE STEM VERTICAL WITH ACTUATOR UP
2. MODEL NO.: VLN400 W/ DAM-D DESUPERHEATER
3. IDENTIFICATION CODE: DRAG-SJA6-16-24BW-36BW-ADGU36-TB
4. ALL DIMENSIONS WITHOUT STATED TOLERANCES ARE FOR REFERENCE ONLY
5. BECHTEL TAGGING TO BE FOLLOWED.
6. SEAT LEAKAGE PER ANSI/FCI 70.2, CLASS V
7. ALL DIMENSIONS ARE IN INCHES
8. HYDROTEST OF VALVE BODY ONLY.
9. ASME PRESSURE CLASS RATED FOR VALVE BODY, DESUPERHEATER SECTION RATED TO ASME B31.1
10. VALVE PROVIDED WITH TWO POSITION TRANSMITERS.
11. HYDROTEST OF VALVE BODY AND DESUPERHEATER.
12. HYDRO TEST OF WATER CONNECTION & MANIFOLD.


CRICKET VALLEY ENERGY CENTER

BECHTEL INFRASTRUCTURE AND POWER CORPORATION


PURCHASE ORDER 26068-230POA-MS00-00001

EQUIPMENT SCOPE: BOP

WARMING LINE CONN: 1" SCH XXS

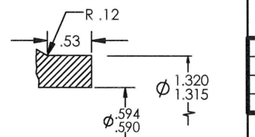


INLET CONNECTION: 24" SCH 40

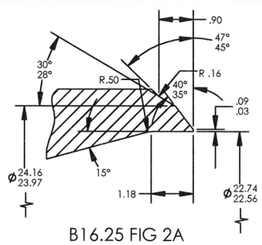


B16.25 FIG 2A

OUTLET CONNECTION: 36" SCH 40

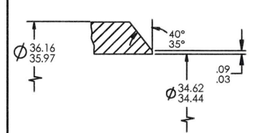

B16.25 FIG 2A


WATER INLET CONN: 4" SCH STD

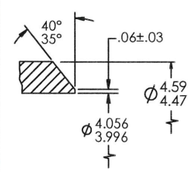

B16.25 FIG 2A

108384-020-03	03-AB-PV-201
108384-020-02	02-AB-PV-201
108384-020-01	01-AB-PV-201
SERIAL NO.	**TAG NO.**

% Cv VS % STROKE

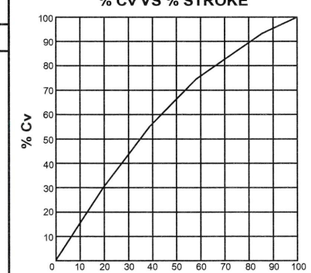

GE ENERGY

GENERAL ELECTRIC COMPANY
GENERAL ELECTRIC INTERNATIONAL, INC.
POWER GENERATION-PROJECT ENGINEERING

GENERAL ASSEMBLY DRAWING

PROJECT NO: 1032773

FIRST MADE FOR CRICKET VALLEY ENERGY CENTER

SIZE	CAGE CODE	DWG NO 800289-4 MDL NO VLN+DAM-D
SCALE	EQUIP NO.	SHEET 1 OF 3

CERTIFICATION

CUSTOMER	GE POWER
P.O.	4101407006
PROJECT	CRICKET VALLY TBS
UNIT	
STATION	CRICKET VALLEY ENERGY CENTER
CONTRACT NO. :	

IMI CCI 22591 Avenida Empresa Rancho Santa Margarita California, 92688 U.S.A. IMI Critical Engineering

DRAG® VALVE

24" X 22" ASME 600 ANGLE VALVE
WITH 24" X 24" INLET EXTENSION AND
22" X 36" DAM-D DESUPERHEATER

PREP:	J. CAGLE	8-AUG-17
CHK:	J. HEIDENREICH	8-AUG-17
DSGN:	J. CAGLE	8-AUG-17
PROJ:	J. HEIDENREICH	8-AUG-17
APVD:	R. GRABLE	8-AUG-17

SIZE D

DRAWING NUMBER 800289-4

SCALE: NONE SHEET 1 OF 3


Document Status: RELEASED


IMI CCI – Digital Paper System


THIS DOCUMENT CONTAINS PROPRIETARY INFORMATION WITH ALL RIGHTS AND TITLES RESERVED AND MAY NOT BE REPRODUCED IN WHOLE OR PART WITHOUT WRITTEN CONSENT OF IMI CCI.


PARTS LIST


ITM	DESCRIPTION	MATERIAL	QTY	REMARKS
A	ACTUATOR	STI	1	SC/V 500
P	POSITIONER	FISHER	1	DVC6200 HW2
TP	PRESSOSTATIC HEAD	STI	1	TP
AFR	AIR FILTER REGULATOR	NORGREN	1	B74 3/4" ALU
BD	DERIVATIVE BOOSTER	STI	4	BD 1"
ZT1	POSITION TRANSMITTER	FISHER	1	INTO POSITIONER
ZT2	POSITION TRANSMITTER	SOLARTRON	1	LVDT
B	CHECK VALVE	NORGREN	1	1/2" ALU
D1-2	3 WAY VALVE	STI	2	CO 1/2"
AB	AIR TANK	MANCHESTER	1	303L
F	AIR FILTER	NORGREN	1	F68 1"
SV	SAFETY VALVE	N.G.L	1	C10 BRASS
DV	DRAIN VALVE	M.B.VALVE	1	IVR 660
G	GAUGE	STI	1	STI
EV	SOLENOID VALVE	MAXSEAL	1	ICO3S
LS	LIMIT SWITCHES	HONEYWELL	2	GLA SERIES
VB	VOLUME BOOSTER	STI	2	AV 1/4"
PS	PRESSURE SWITCH	TELEMELANIQUE	1	XMLA010A2S11

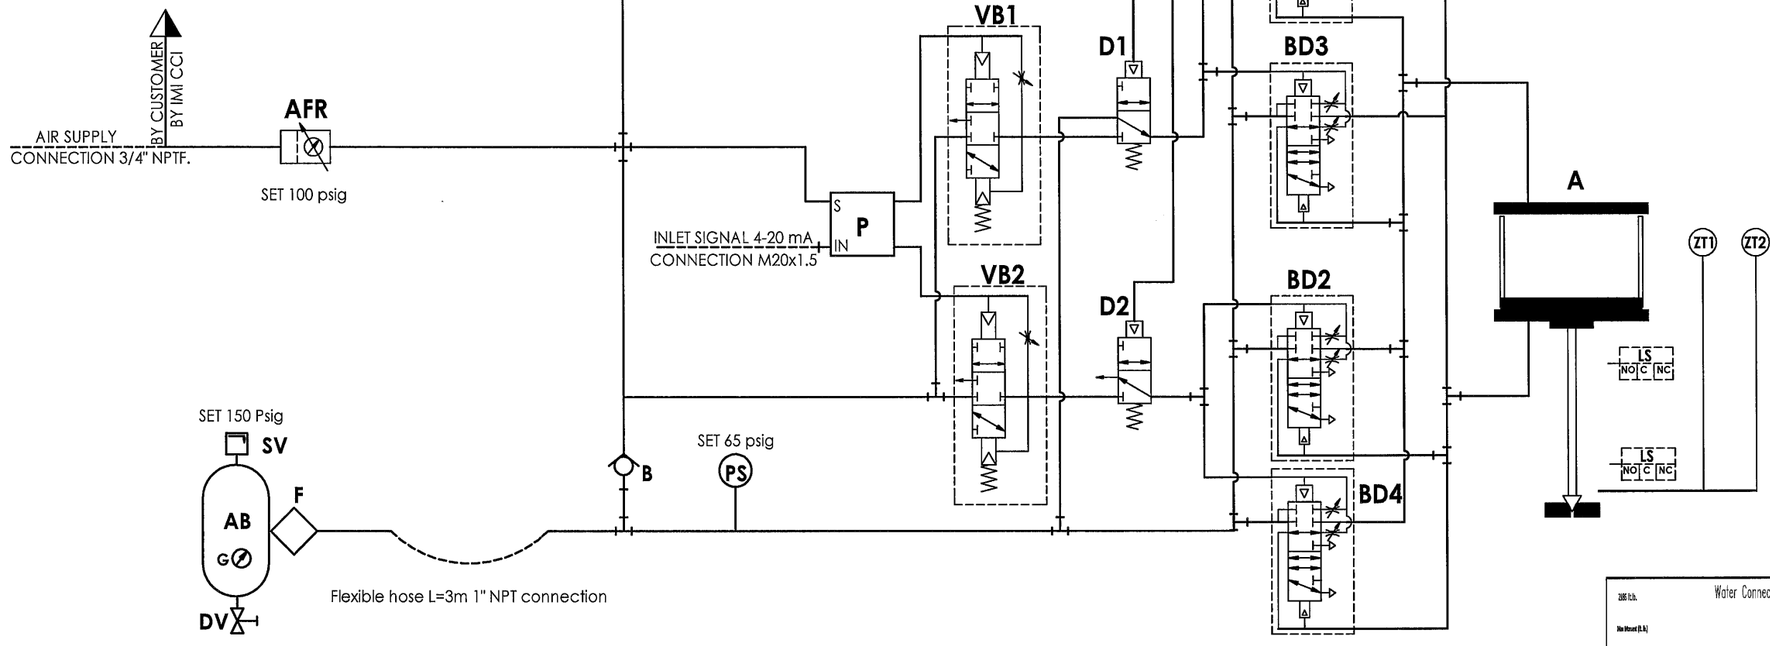

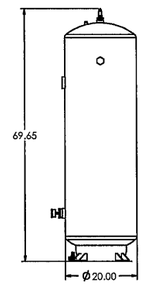

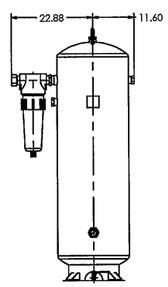


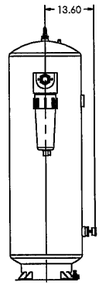

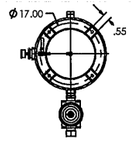


VALVE TAG NO.	TANK TAG NO.
01-AB-PV-201	01-AB-MT-201
02-AB-PV-201	02-AB-MT-201
03-AB-PV-201	03-AB-MT-201

CONTROL LOGIC				
SIGNAL	OK	ANY	FAIL	ANY
SOLENOID	ENERGIZED	ENERGIZED	ENERGIZED	DE-ENERGIZED
AIR SUPPLY	OK	FAIL	OK	OK
VALVE POSITION	MODULATING	CLOSE	CLOSE	CLOSE

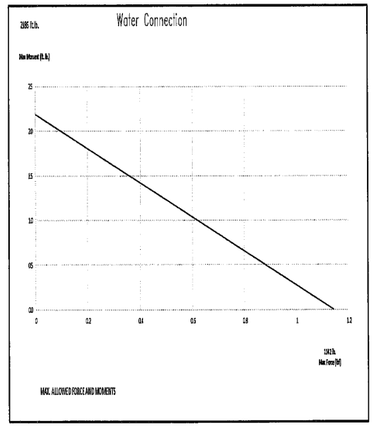


SIZE	DRAWING NUMBER
D	800289-4
REVISION C	SHEET 2 OF 3

Document Status: RELEASED

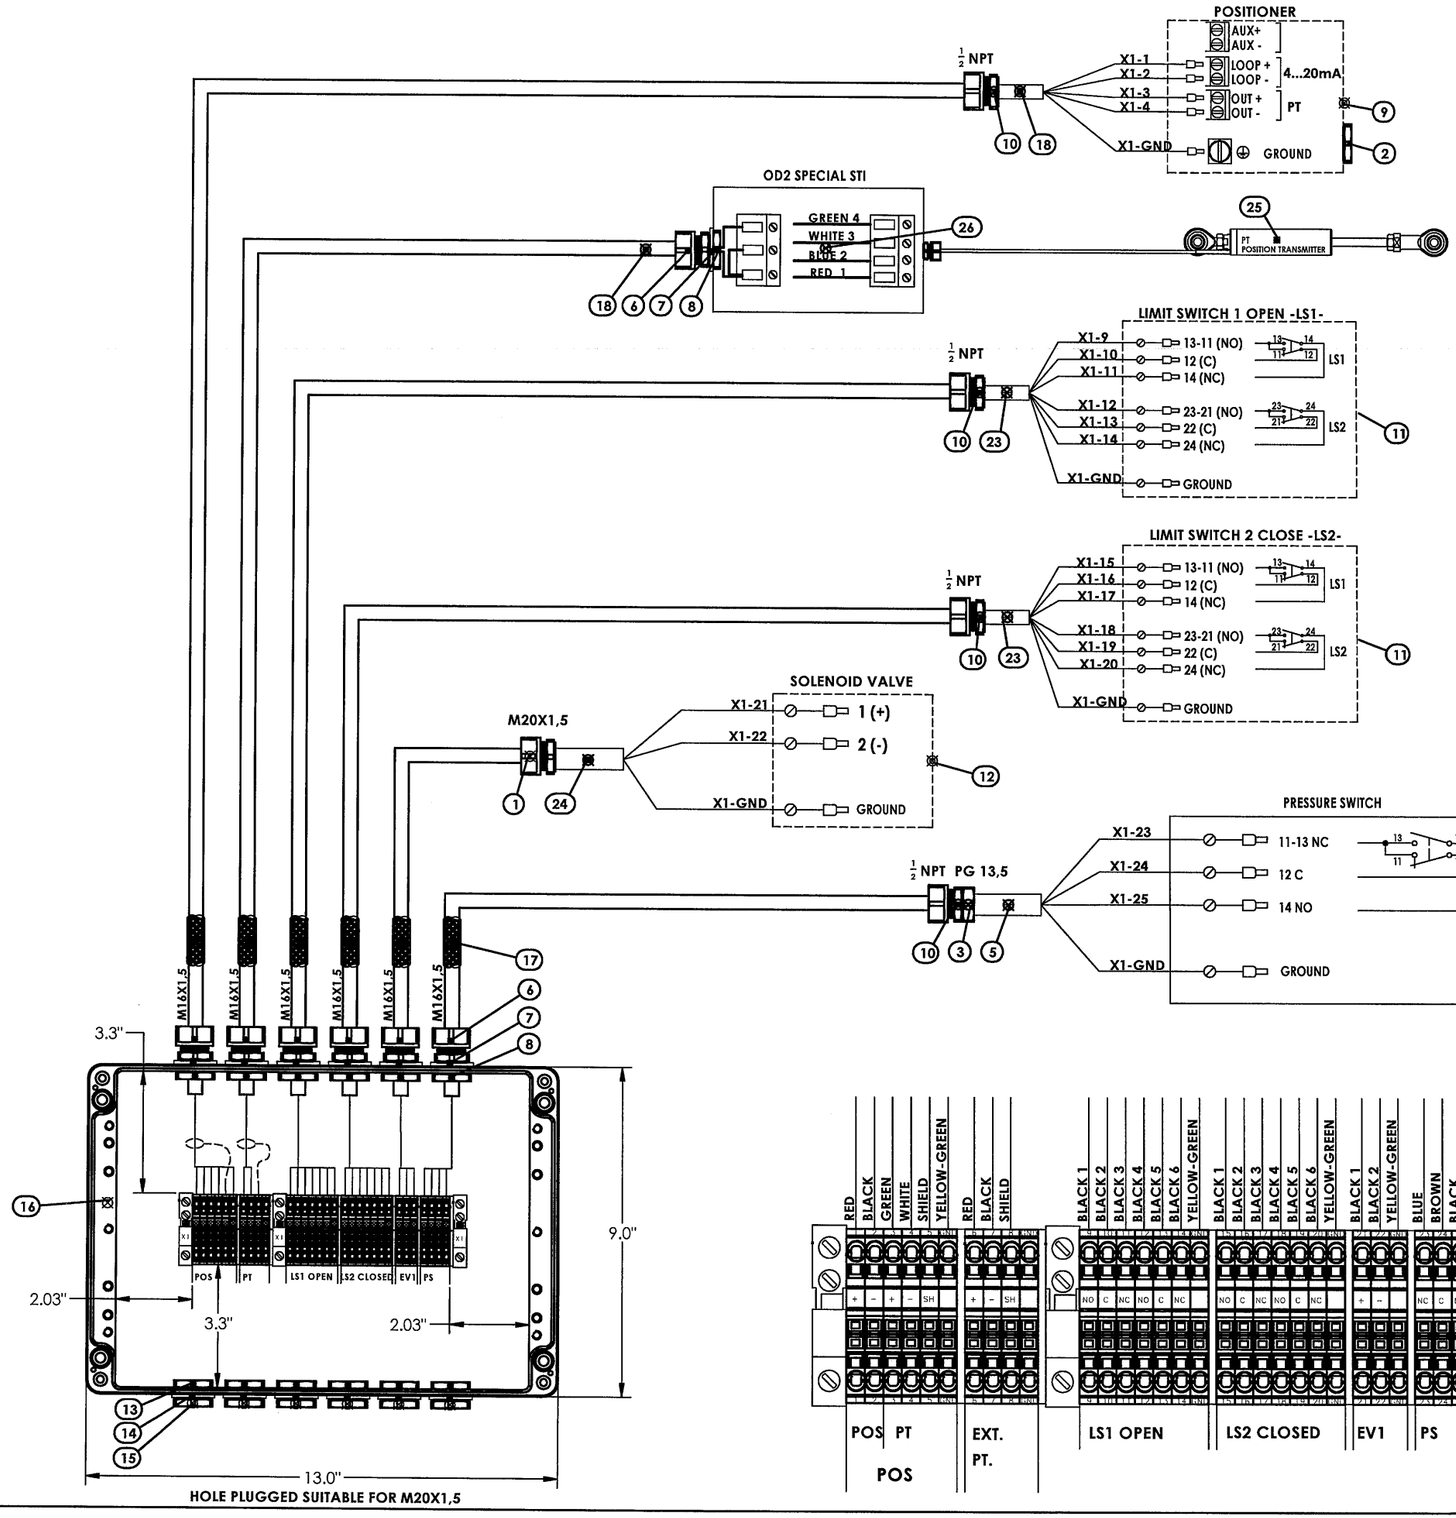

Item	Qty	Description	Vendor	Part number
1	1	CONDUIT FITTING	ANAMET 712.117.9	147025
2	1	HOLE PLUG	PEPPERS SPMH1SF/050NPT 1/2NPT	109236
3	1	ADAPTER	PEPPERS AR0SF/PG13/050NPT	149509
4	1	PRESSURE SWITCH	TELEMECANIQUE XMLA010A2S11	
5	1	CABLE	ELETTROTEKKABEL FROR 4G1 CC500	109333
6	7	CABLE CONDUIT	ANACONDA M16X1.5 712.116.9	109197
7	7	GASKET	PEPPERS ACNSW/M16	109206
8	7	LOCKNUT	PEPPERS ACSLN/M16	109204
9	1	POSITIONER	FISHER 6200 HC HW2	
10	4	CONDUIT GLAND	ANACONDA STEALTITE 1/2"NPT 714.112.9 AISI 316	109193
11	2	LIMIT SWITCH	HONEYWELL GLAA DPDT	
12	1	SOLENOID VALVE	MAXSEAL ICO3S	
13	6	LOCKNUT	PEPPERS ACSLN/M20 M20X1.5	109202
14	6	GASKET	PEPPERS ACNSW/M20 M20X1.5	109205
15	6	HOLE PLUG	PEPPERS SPMH1SF/M20	109234
16	1	JUNCTION BOX	ROSE 25.23.33.11	122074
17	6	CONDUIT	ANACONDA STEALTITE H.T.D.L. 3/8" 330.012.2	109213
18	2	CABLE	ELETTROTEKKABEL SRY D321C 4X22 03210422	109216
19	25	TERMINAL	PHOENIX CONTACT ST 2,5	111755
20	3	TERMINAL STOP	PHOENIX CONTACT E/UK	109221
21	6	TERMINAL SEPARATOR	PHOENIX CONTACT TYPE D-ST 2.5	111754
22	6	GROUND TERMINAL	PHOENIX CONTACT ST 2.5-PE	111756
23	2	CABLE	ELETTROTEKKABEL FROR 7G1 CC500	109291
24	1	CABLE	ELETTROTEKKABEL FROR 3G1 CC500	109289
25	1	POSITION TRANSMITTER	SOLARTRON LVDT S-SERIES	
26	1	PT CONVERTER	SOLARTRON OD2 SPECIAL STI	

HOLES ORIENTATION

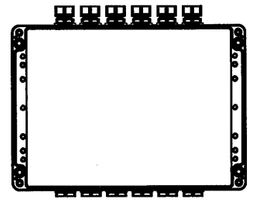

HOLE PLUGGED SUITABLE M20X1,5
CUSTOMER SIDE

HOLES ORIENTATION AND POSITION ARE INDICATIVE. THEY COULD BE CHANGED DURING THE MOUNTING.

SIZE	DRAWING NUMBER
D	800289-4
REVISION C	SHEET 3 OF 3